


LEGEND

ABBREVIATIONS	
INV	PIPE INVERT ELEVATION
RCP	REINFORCED CONCRETE PIPE
HDPE	HIGH DENSITY POLYETHYLENE
LP	LIGHT POLE
TEST	TEST LOCATION
SS	STORM SEWER LINE

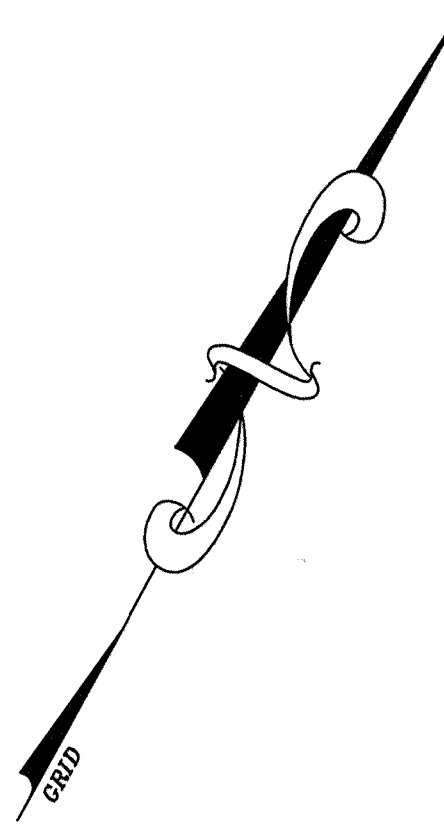

TMS # 066-00-01-005
J JEMSEY JONES
BLACKWATER LLC
(DB. 1970 PG. 1055)

TMS # 066-00-01-006
LAWRIMORE FLORA MAE
N/F

TMS # 066-00-01-011
CHILDS ANNIE LAURA
N/F

NEW POND #4 (DRY)
TOP BANK = 94.66'
HIGH WATER (25 YR.) = 90.762'
NORMAL WATER = 90.09'
BOTTOM BANK = 90.09'
WATER LEVEL (100 YR.) = 91.128'

HAGOOD DR (EXISTING)

TMS # 065-00-03-092
LOT 10
LARSON DUANE
N/F

TMS # 065-00-03-091
LOT 9
JOHNSON ANDREA
(DB. 3086 PG. 1199)


TMS # 065-00-03-077
HUCKS CARL T
(DB. 2529 PG. 321)

TMS # 065-00-03-076
SHELLEY ERIC A & BUFFY W
(DB. 2529 PG. 600)

TMS # 066-00-01-132
ISSAC S. LEWIS, JR.
(DB. 2713 PG. 804)

TMS # 065-00-01-140
ISSAC S. LEWIS, JR.
(DB. 3018 PG. 1313)

GRAPHIC SCALE

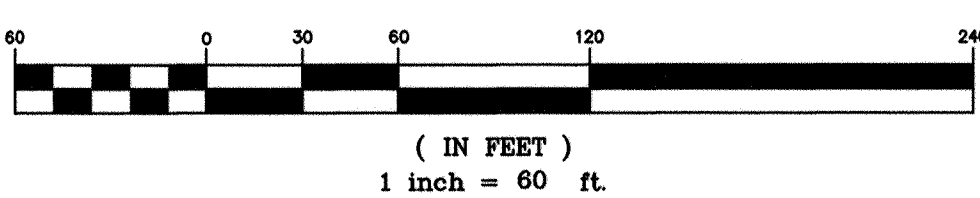

NOTES

- OWNER IS: GREENFIELD ESTATES, LLC.
1088 D STREET
CONWAY, S.C. 29527
(843) 997 6096
- DEVELOPER: SAME AS ABOVE
- CONTRACTOR: GOODSON CONSTRUCTION COMPANY INC.
P.O. BOX 32
AYROR, SC 29511
(843) 358 3566
- DEVELOPMENT PARCEL IS LOCATED WITHIN A FLOOD HAZARD ZONE "X" (AREA DETERMINED TO BE OUTSIDE 500-YEAR FLOODPLAIN) AS PER F.I.R.M. MAP NUMBER 450104 PANEL 0325 SUFFIX H. FLOOD ZONE INFORMATION SUBJECT TO VERIFICATION BY COMMUNITY FLOOD ZONE MANAGER.
- ELEVATIONS ARE BASED ON NAVD 1988 DATUM.
- ALL DRAINAGE EASEMENTS ARE TO REMAIN CLEAR AND FREE OF STRUCTURES OR OBSTRUCTIONS. DRAINAGE EASEMENTS ALONG DRAINAGE PIPES SHALL ALSO BE USED FOR ACCESS TO COMMON AREAS FOR MAINTENANCE.
- FINISHED FLOOR ELEVATIONS ARE TO BE 1' ABOVE THE CENTERLINE OF THE ROAD OR BACK OF CURB.
- ALL ACTIVITIES, INCLUDING ACTIVITIES BY INDIVIDUAL LOT OWNERS OR LEASEHOLDERS, WILL BE CARRIED OUT IN ACCORDANCE WITH THE APPROVED STORMWATER MANAGEMENT AND SEDIMENT CONTROL PLAN FOR THE SUBDIVISION.
- ALL PONDS, ROADS, LAKES, BERM, COMMON AREAS, AND OPEN SPACES ARE TO BE OWNED AND MAINTAINED BY THE POA.
- ALL DRAINAGE STRUCTURES ARE TO BE OWNED AND MAINTAINED BY THE POA, UNLESS NOTED AS PUBLIC.
- ALL PRIVATE DRAINAGE EASEMENTS SHALL ALSO INCLUDE RIGHT OF ACCESS FOR MAINTENANCE OF PIPES, PONDS, STRUCTURES AND APPURTENANCES.
- COORDINATES ARE BASED ON NAD 83.

STORMWATER CERTIFICATION

I HEREBY STATE THAT THE FACILITIES HAVE BEEN CONSTRUCTED AS SHOWN HEREON, AND THE FACILITIES MEET THE APPROVED STORMWATER MANAGEMENT AND SEDIMENT CONTROL PLAN AND SPECIFICATIONS TO ACHIEVE THE FUNCTION FOR WHICH THEY WERE DESIGNED.

JEFFREY D. SOLAN, P.E., P.L.S.
SC REG. # 19407

9-11-08
DATE











DRAINAGE SYSTEM RECORD DRAWING

GREENFIELD ESTATES
SC HWY #128
HORRY COUNTY, SOUTH CAROLINA
PREPARED FOR: GREENFIELD ESTATES, LLC

FILE NO. 06-065
SCALE As Noted
DATE 5-12-08
DRAWN BY CH
CHECKED BY
DWG NO.
D-1
SHEET 1 OF 2

JEFFREY D. SOLAN & ASSOCIATES, P.C.
ENGINEERING, PLANNING & LAND SURVEYING
PO Box 870
Conway, SC 29528
Office: (843) 488-3400
Fax: (843) 488-3401

THIS DOCUMENT IS THE PROPERTY OF JEFFREY D. SOLAN & ASSOCIATES, P.C. AND ALL COPYRIGHTS ARE RESERVED AS OF THE DATE SHOWN HEREON. COPIES OF THIS DOCUMENT WITHOUT ENGINEER'S/SURVEYOR'S SEAL AND SIGNATURE ARE INVALID.

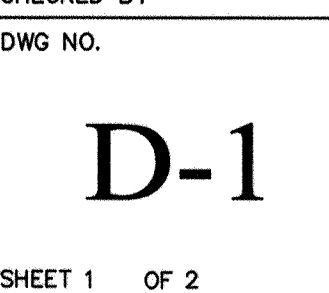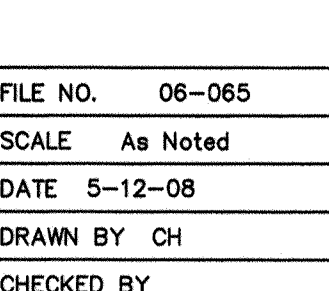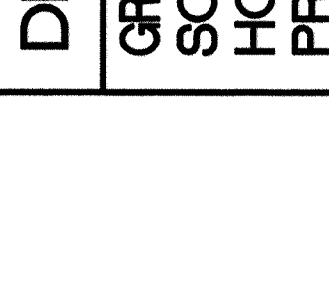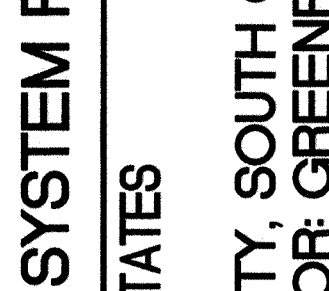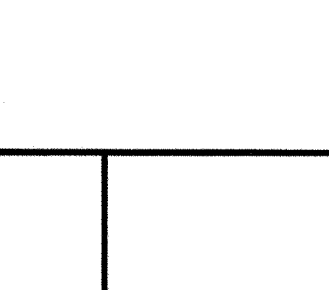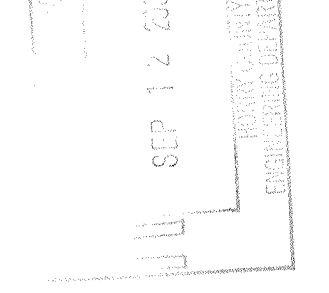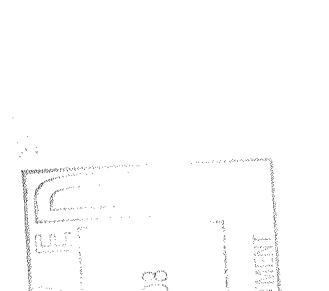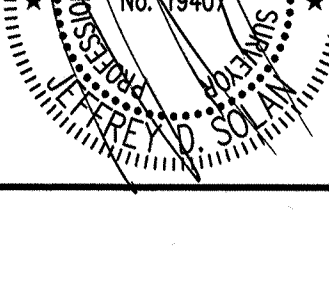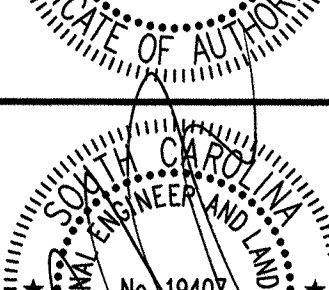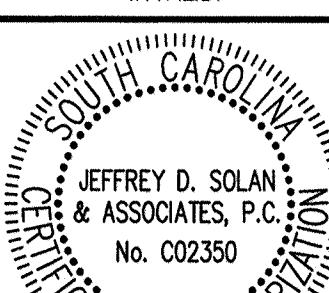

LEGEND


ABBREVIATIONS

INV PIPE INVERT ELEVATION
RCP REINFORCED CONCRETE PIPE
HDPE HIGH DENSITY POLYETHYLENE
L.P. LIGHT POLE
X TEST LOCATION
--- STORM SEWER LINE

OUTFALL STRUCTURE #2
TOP = 98.18
INV IN (POND) = 94.32
INV OUT (CB #31) = 94.24
SUMP = 93.05
N 793298
E 2539378




TMS # 066-00-01-012
LEWIS DEBORAH LEE & MARILYN D BERRY
(DB. 2417 PG. 1165)

NEW POND #3
TOP BANK = 100.76'
HIGH WATER (25 YR.) = 95.249'
NORMAL WATER = 94.54'
BOTTOM BANK = 90.36'
WATER LEVEL (100 YR) = 95.799'

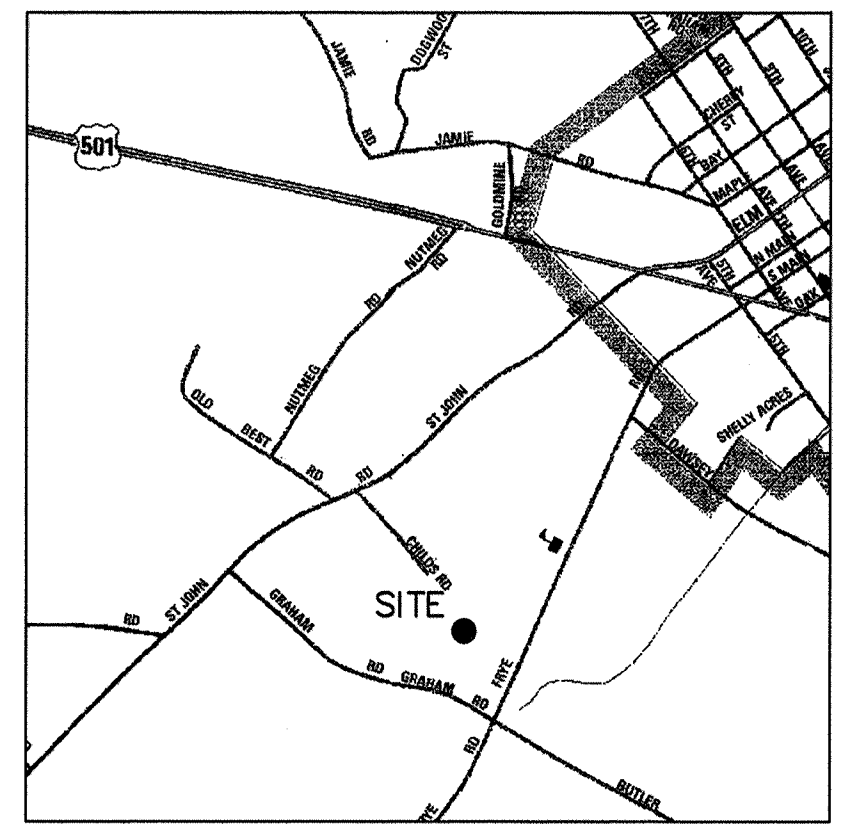

JEFFREY D. SOLAN & ASSOCIATES, P.C.
ENGINEERING, PLANNING & LAND SURVEYING
Office: (843) 488-3400
Fax: (843) 488-3401
NO. 1000
Conway, SC 29528

THIS DOCUMENT IS THE PROPERTY OF JEFFREY D. SOLAN & ASSOCIATES, P.C., AND ALL COPYRIGHTS ARE RESERVED AS OF THE DATE SHOWN HEREON. COPIES OF THIS DOCUMENT WITHOUT THE ENGINEER'S/SURVEYOR'S SEAL AND SIGNATURE ARE INVALID.

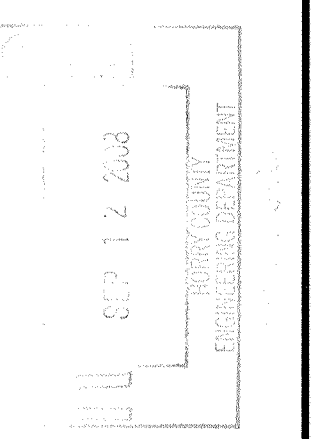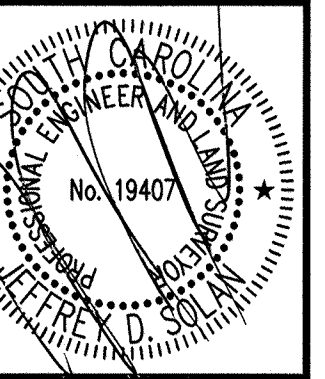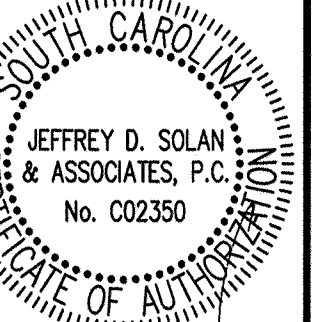


DRAINAGE SYSTEM RECORD DRAWING
GREENFIELD ESTATES
SC HWY #128
HORRY COUNTY, SOUTH CAROLINA
PREPARED FOR: GREENFIELD ESTATES, LLC

FILE NO. 06-065
SCALE As Noted
DATE 5-12-08
DRAWN BY CH
CHECKED BY
DWG NO.
D-2
SHEET 2 OF 2


NOTES

- OWNER IS: GREENFIELD ESTATES, LLC.
1098 D STREET
CONWAY, S.C. 29527
(843) 997 6096
- DEVELOPER: SAME AS ABOVE
- CONTRACTOR: GOODSON CONSTRUCTION COMPANY INC.
P.O. BOX 39
ATYOR, SC 29511
(843) 358 3556
- DEVELOPMENT PARCEL IS LOCATED WITHIN A FLOOD HAZARD ZONE "X" (AREA DETERMINED TO BE OUTSIDE 500-YEAR FLOODPLAIN) AS PER F.I.R.M. MAP NUMBER 4505100325 H, MAP REVISION DATE AUG. 23, 1999, COMMUNITY NUMBER 450104 PANEL 0325 SUFFIX H. FLOOD ZONE INFORMATION SUBJECT TO VERIFICATION BY COMMUNITY FLOOD ZONE MANAGER.
- ELEVATIONS ARE BASED ON NAVD 1988 DATUM.
- ALL DRAINAGE EASEMENTS ARE TO REMAIN CLEAR AND FREE OF STRUCTURES OR OBSTRUCTIONS. DRAINAGE EASEMENTS ALONG DRAINAGE PIPES SHALL ALSO BE USED FOR ACCESS TO COMMON AREAS FOR MAINTENANCE.
- FINISHED FLOOR ELEVATIONS ARE TO BE 1' ABOVE THE CENTERLINE OF THE ROAD OR BACK OF CURB.
- ALL ACTIVITIES, INCLUDING ACTIVITIES BY INDIVIDUAL LOT OWNERS OR LEASEHOLDERS, WILL BE CARRIED OUT IN ACCORDANCE WITH THE APPROVED STORMWATER MANAGEMENT AND SEDIMENT CONTROL PLAN FOR THE SUBDIVISION.
- ALL PONDS, ROADS, LAKES, BERMS, COMMON AREAS, AND OPEN SPACES ARE TO BE OWNED AND MAINTAINED BY THE POA.
- ALL DRAINAGE STRUCTURES ARE TO BE OWNED AND MAINTAINED BY THE POA, UNLESS NOTED AS PUBLIC.
- ALL PRIVATE DRAINAGE EASEMENTS SHALL ALSO INCLUDE RIGHT OF ACCESS FOR MAINTENANCE OF PIPES, PONDS, STRUCTURES AND APPURTENANCES.
- COORDINATES ARE BASED ON NAD 83.

STORMWATER CERTIFICATION--
I HEREBY STATE THAT THE FACILITIES HAVE BEEN CONSTRUCTED AS SHOWN HEREON, AND THE FACILITIES MEET THE APPROVED STORMWATER MANAGEMENT AND SEDIMENT CONTROL PLAN AND SPECIFICATIONS OR ACHIEVE THE FUNCTION FOR WHICH THEY WERE DESIGNED.
JEFFREY D. SOLAN, P.E., P.L.S.
SC REG # 19407
DATE 9-11-08

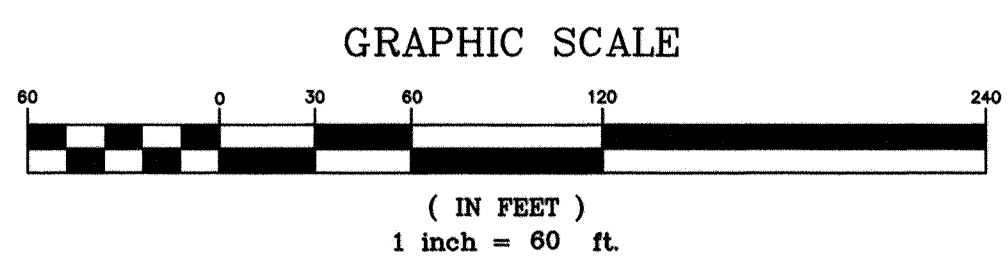

OUTFALL STRUCTURE #2 DETAIL

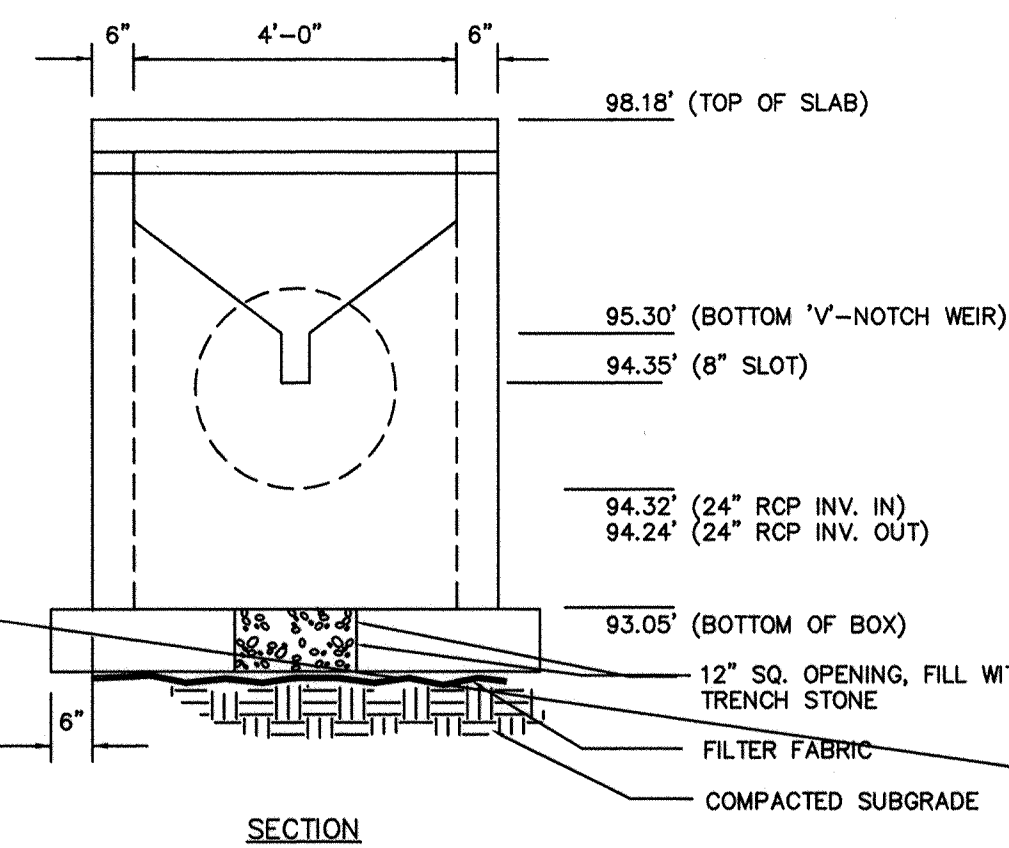

OUTFALL STRUCTURE #1 DETAIL

